


SCHEDULE OF RELOCATION			
EXISTING CEMETERY		RELOCATED CEMETERY	
GRAVE NO.	NAME	CEM. NO.	GRAVE NO.
1	INFANT FATELY	BSC-6-R	31
2	INFANT FATELY	"	32

- NOTES:
- GRAVES IN THIS CEMETERY TO BE RELOCATED IN NEW PEEL CEMETERY B.S.C.-6-R. SEE SHEET 13 FOR LAYOUT.
 - VEHICLE ACCESS VIA DUGGINSVILLE, MISSOURI.
 - TRANSPORT REMAINS BY BOAT ACROSS WHITE RIVER. SEE SHEET 2 FOR NEAREST ROUTE TO REINTERMENT CEMETERY.

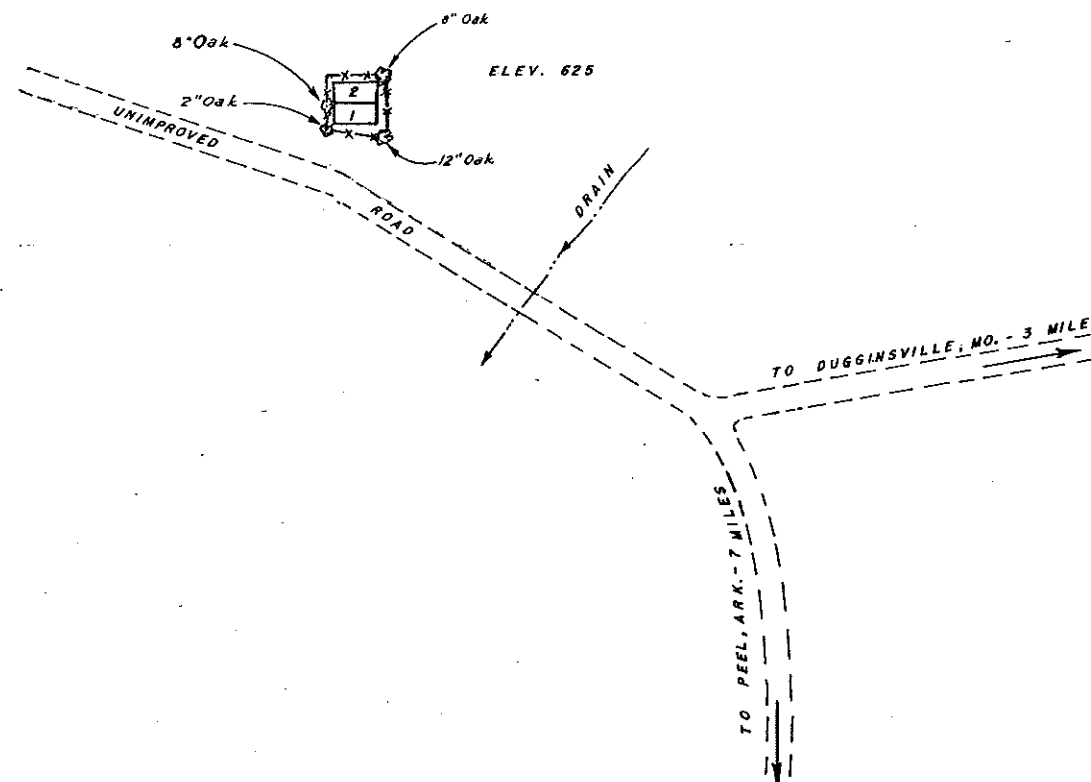

RECORD DRAWING AS CONSTRUCTED
[Signature] 6-15-50

WHITE RIVER WATERSHED WHITE RIVER, ARKANSAS
BULL SHOALS RESERVOIR
CEMETERY RELOCATION
FATELY CEMETERY NO. B.S.46

IN 16 SHEETS SCALE: 1:240 SHEET NO. 9
20 0 20 40 60
SCALE OF FEET

LITTLE ROCK DIST., LITTLE ROCK, ARK., MAR. 1948
SUBMITTED: APPROVAL REC'D: APPROVED
[Signature] *[Signature]* *[Signature]*
HEAD, RELOC. SEC. CHIEF, ENGRG. DIV. COL., CORPS ENGRS.
DISTRICT ENGINEER

DRAWN A.M.H. SERIAL 5900
TRACED
CHECKED O.L.G. FILE 139/1649